


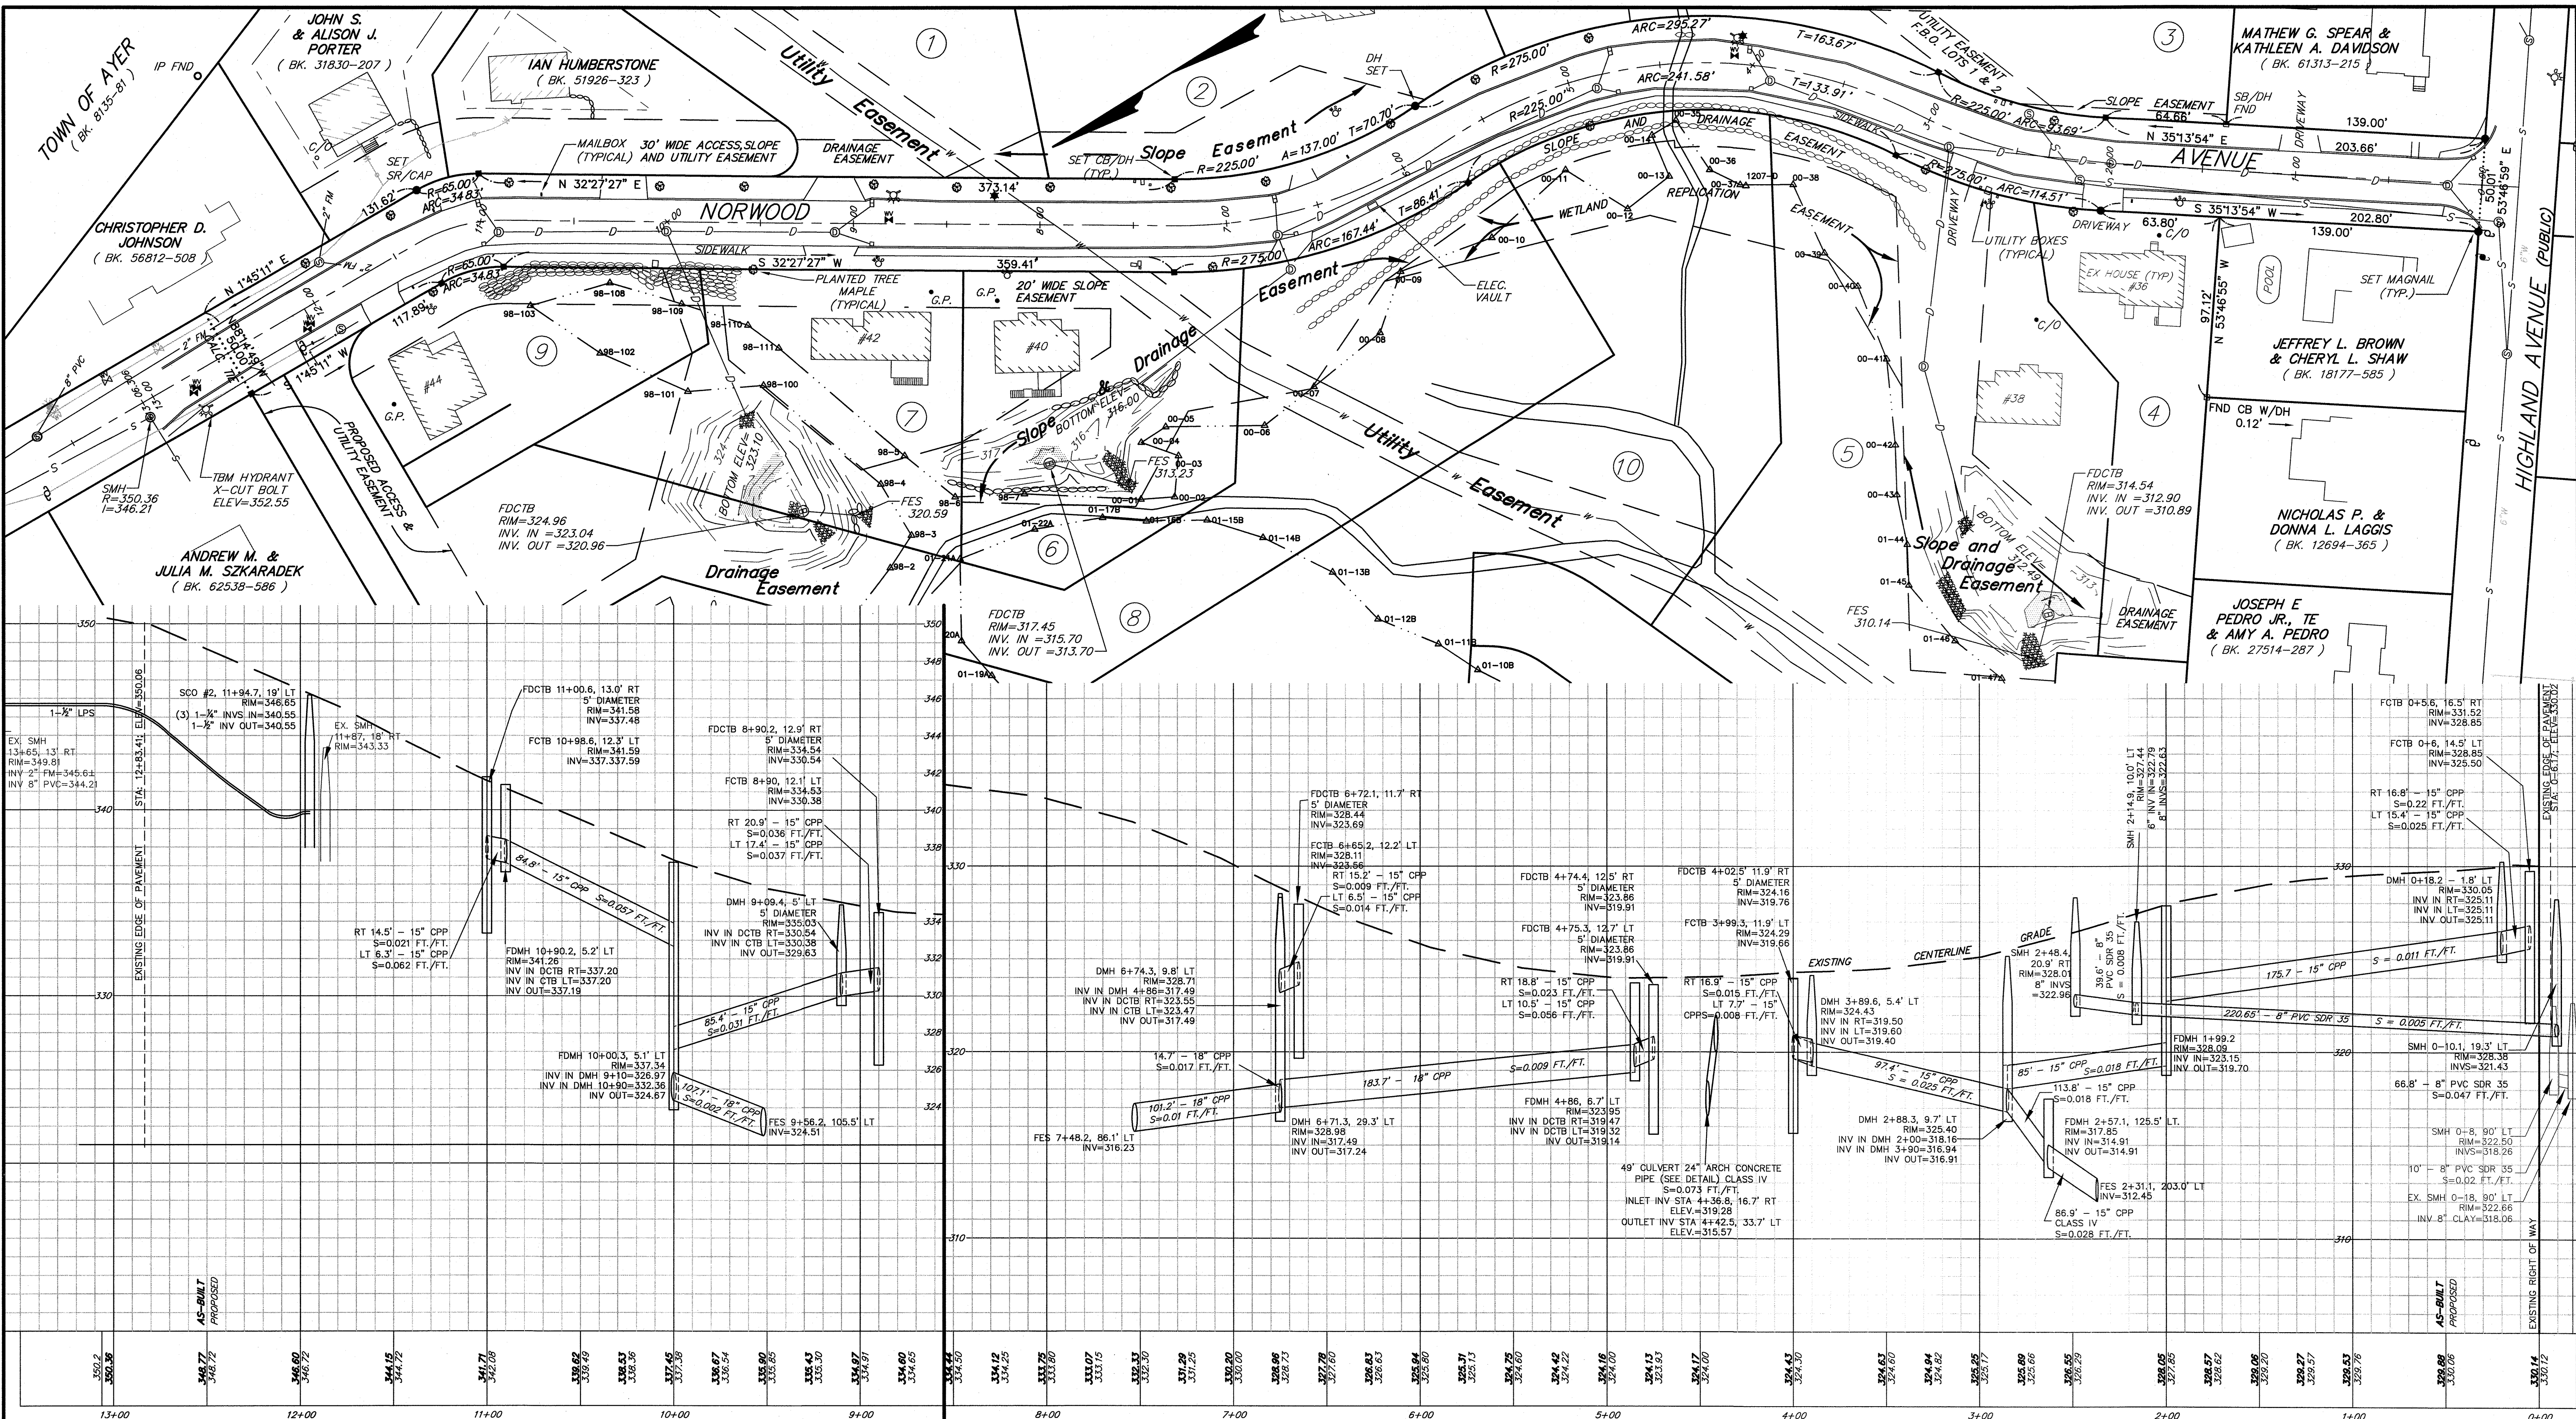

Legend

- | | | | | | |
|-------|------------------------------|---|------------------------------------|--------|-----------------------------------|
| — | GRANITE CURB & CAPE COD BERM | ■ | SET CONCRETE BOUND WITH DRILL HOLE | • G.P. | GRINDING PUMP |
| — | EDGE PAVEMENT | ● | SET MAGNAIL | ● | SET STEEL ROD WITH SURVEYOR'S CAP |
| □ | UTILITY BOXES | ⊙ | MAPLE TREE | | |
| — W — | WATER LINE AND GATE | ⊙ | SEWER MANHOLE | | |
| ⊙ | HYDRANT | □ | CATCH BASIN | | |
| ⊙ | WATER SHUT OFF | — | MAIL BOX | | |
| ⊙ | DRAIN MANHOLE | — | DRAIN LINE | | |
| □ | CATCH BASIN | — | SEWER LINE | | |
| □ | DOUBLE CATCH BASIN | — | SEWER CLEANOUT | | |
| | | — | WATER SERVICE | | |


SCALE

VERT. 1" = 4'
HORV. 1" = 40'

THIS PLAN SHOWS ONLY THOSE FEATURES THAT WERE VISUALLY APPARENT ON THE DATE OF THE AS-BUILT SURVEY. THE LOCATION OF UNDERGROUND UTILITIES ARE NOT KNOWN TO THE ENGINEER AND THEREFORE ANY LOCATIONS ARE APPROXIMATE. THE ABSENCE OF THE UNDERGROUND UTILITIES IS NEITHER IMPLIED OR INTENDED.

UNDERGROUND UTILITIES LOCATIONS ARE FROM CONTRACTOR SKETCHES AND ARE APPROXIMATE ONLY.

SEE "ELIZABETH ESTATES" DEFINITIVE SUBDIVISION PLAN PREPARED FOR NORTH SHIRLEY REALTY TRUST, RECORDED IN MIDDLESEX SOUTH REGISTRY OF DEEDS AS PLAN NO. 90 OF 2007.

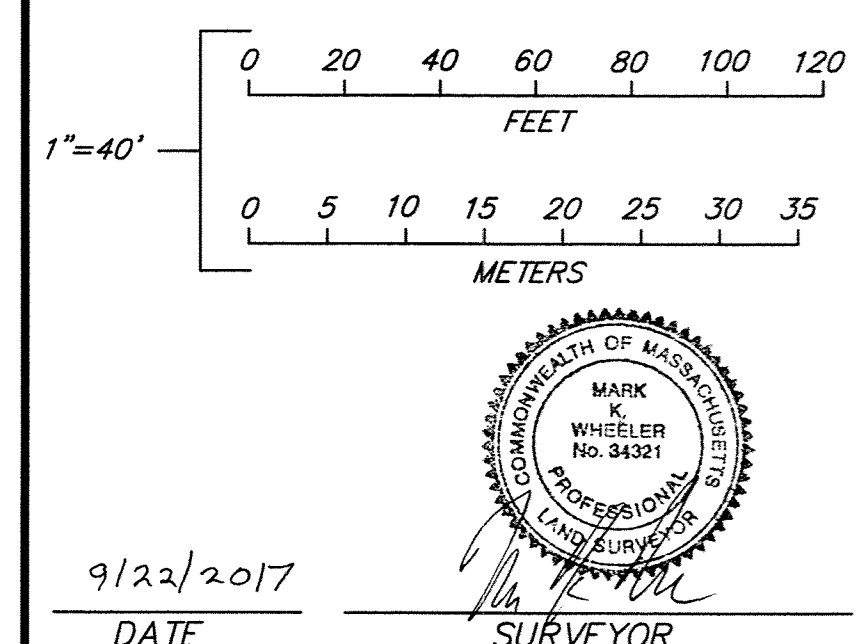

ROAD ACCEPTANCE PLAN OF LAND IN
Ayer, Mass.
PREPARED FOR
North Shirley Realty Trust
SCALE: 1"=40' SEPTEMBER, 2017

David E. Ross Associates, Inc.
CIVIL ENGINEERS — LAND SURVEYORS
ENVIRONMENTAL CONSULTANTS
PO BOX 795-6 LANCASTER COUNTY RD, HARVARD, MA 01451
(TEL. NO. 978-772-6232)

JOB NO. 15105 PLAN NO. L-9935-AB

REF: NB 426-155, NB 787-70