

DEPARTMENT OF PUBLIC WORKS

Mark L. Wetzel, P.E., Superintendent
Dan Van Schalkwyk, P.E. Town Engineer
Pamela J. Martin, Business Manager


25 BROOK STREET
AYER, MASSACHUSETTS 01432
T: (978) 772-8240
F: (978) 772-8244

Addenda
Request for Proposals
Main Street and Columbia Street Roadway Improvement Project
Contract No. 20DPW08
January 21, 2020

Attached are:

- “As-Built” drawings for the Main Street Project completed in 1985.
- Preproposal Meeting Sign In Sheet

WEST MAIN STREET PHASE II (N.I.C.)

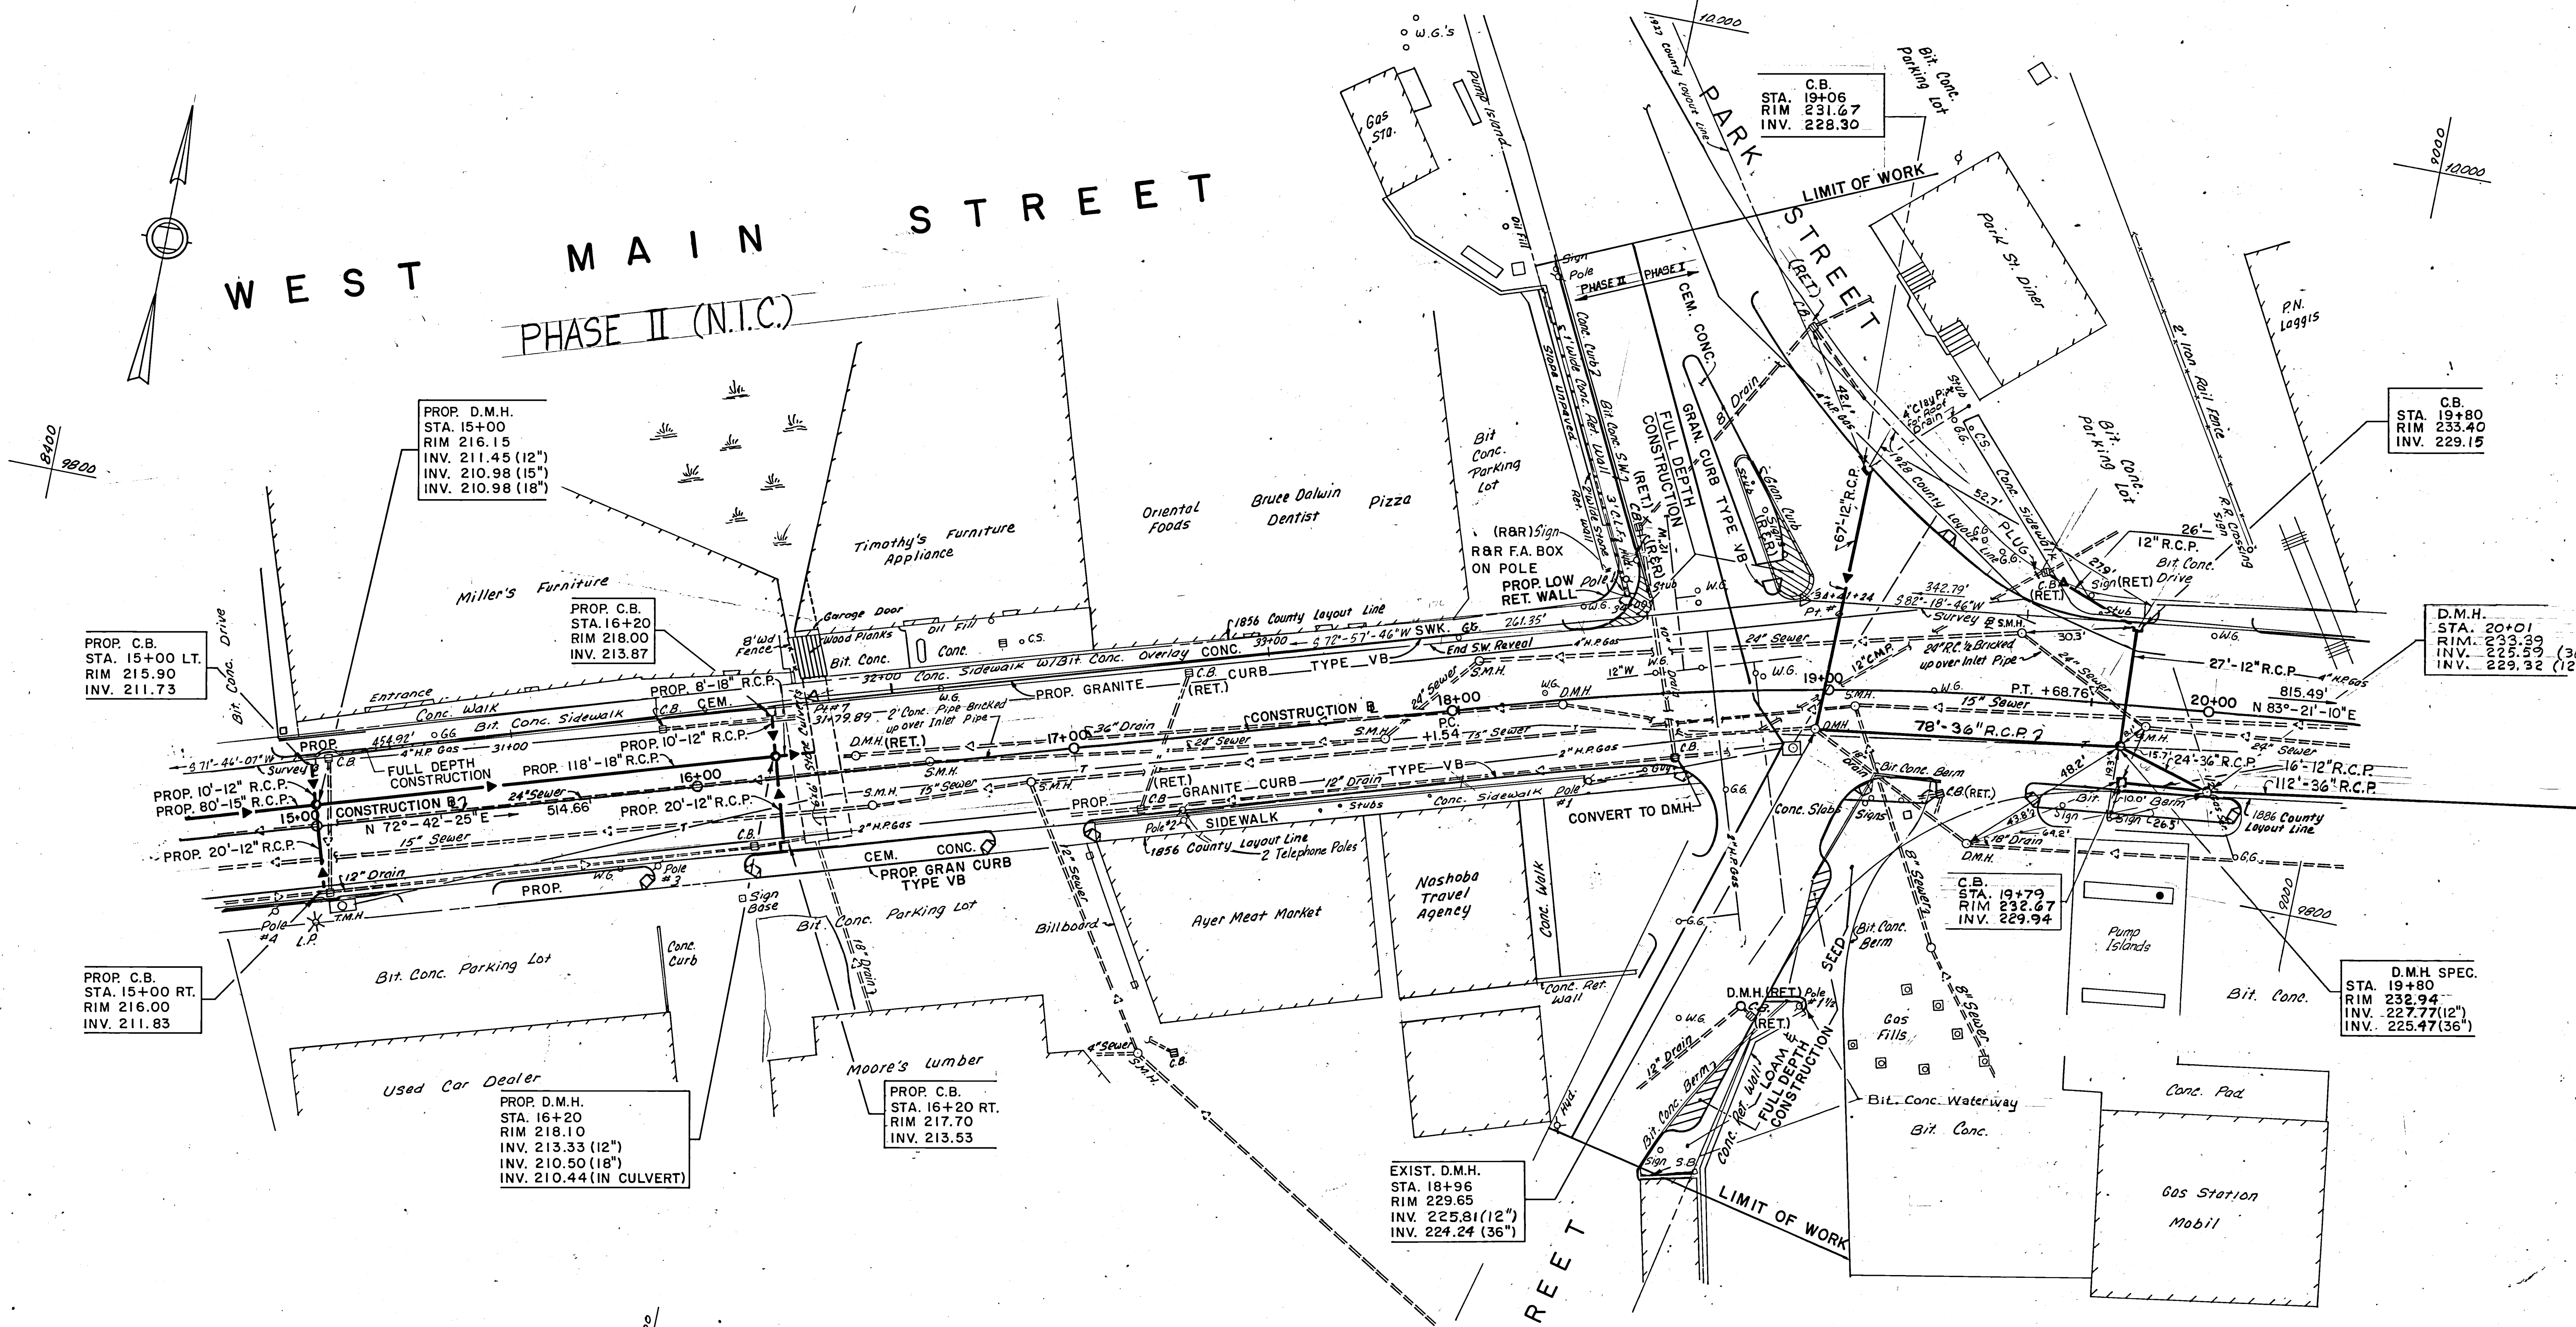

PROP. D.M.H.
STA. 15+00
RIM 216.15
INV. 211.45 (12")
INV. 210.98 (15")
INV. 210.98 (18")

PROP. C.B.
STA. 15+00 LT.
RIM 215.90
INV. 211.73

PROP. C.B.
STA. 16+20
RIM 218.00
INV. 213.87

PROP. C.B.
STA. 15+00 RT.
RIM 216.00
INV. 211.83

PROP. D.M.H.
STA. 16+20
RIM 218.10
INV. 213.33 (12")
INV. 210.50 (18")
INV. 210.44 (IN CULVERT)

PROP. C.B.
STA. 16+20 RT.
RIM 217.70
INV. 213.53

EXIST. D.M.H.
STA. 18+96
RIM 229.65
INV. 225.81 (12")
INV. 224.24 (36")

C.B.
STA. 19+06
RIM 231.67
INV. 228.30

C.B.
STA. 19+80
RIM 233.40
INV. 229.15

D.M.H.
STA. 20+01
RIM 233.39
INV. 225.59 (36")
INV. 229.32 (12")



C.B.
STA. 19+79
RIM 232.67
INV. 229.94

D.M.H. SPEC.
STA. 19+80
RIM 232.94
INV. 227.77 (12")
INV. 225.47 (36")

| | |
|----------------------------|-------------------------|
| 4-25-85 DRAINAGE REVISED | |
| DATE REVISIONS | |
| TOWN OF AYER MASSACHUSETTS | |
| DOWNTOWN REVITALIZATION | |
| CONSTRUCTION PLAN | |
| STA. 15+00 TO STA. 20+00 | |
| | |
| SCALE: 1" = 20' | G.I.A. PROJECT NO. 8407 |
| APPROVED: _____ | DESIGNED BY: J.J.M. |
| DATE: _____ | DRAWN BY: D.K. |
| | CHECKED BY: J.F.M. |
| | PLAN NO. 8 OF 20 |


AS-BUILT DRAWING

HW #46

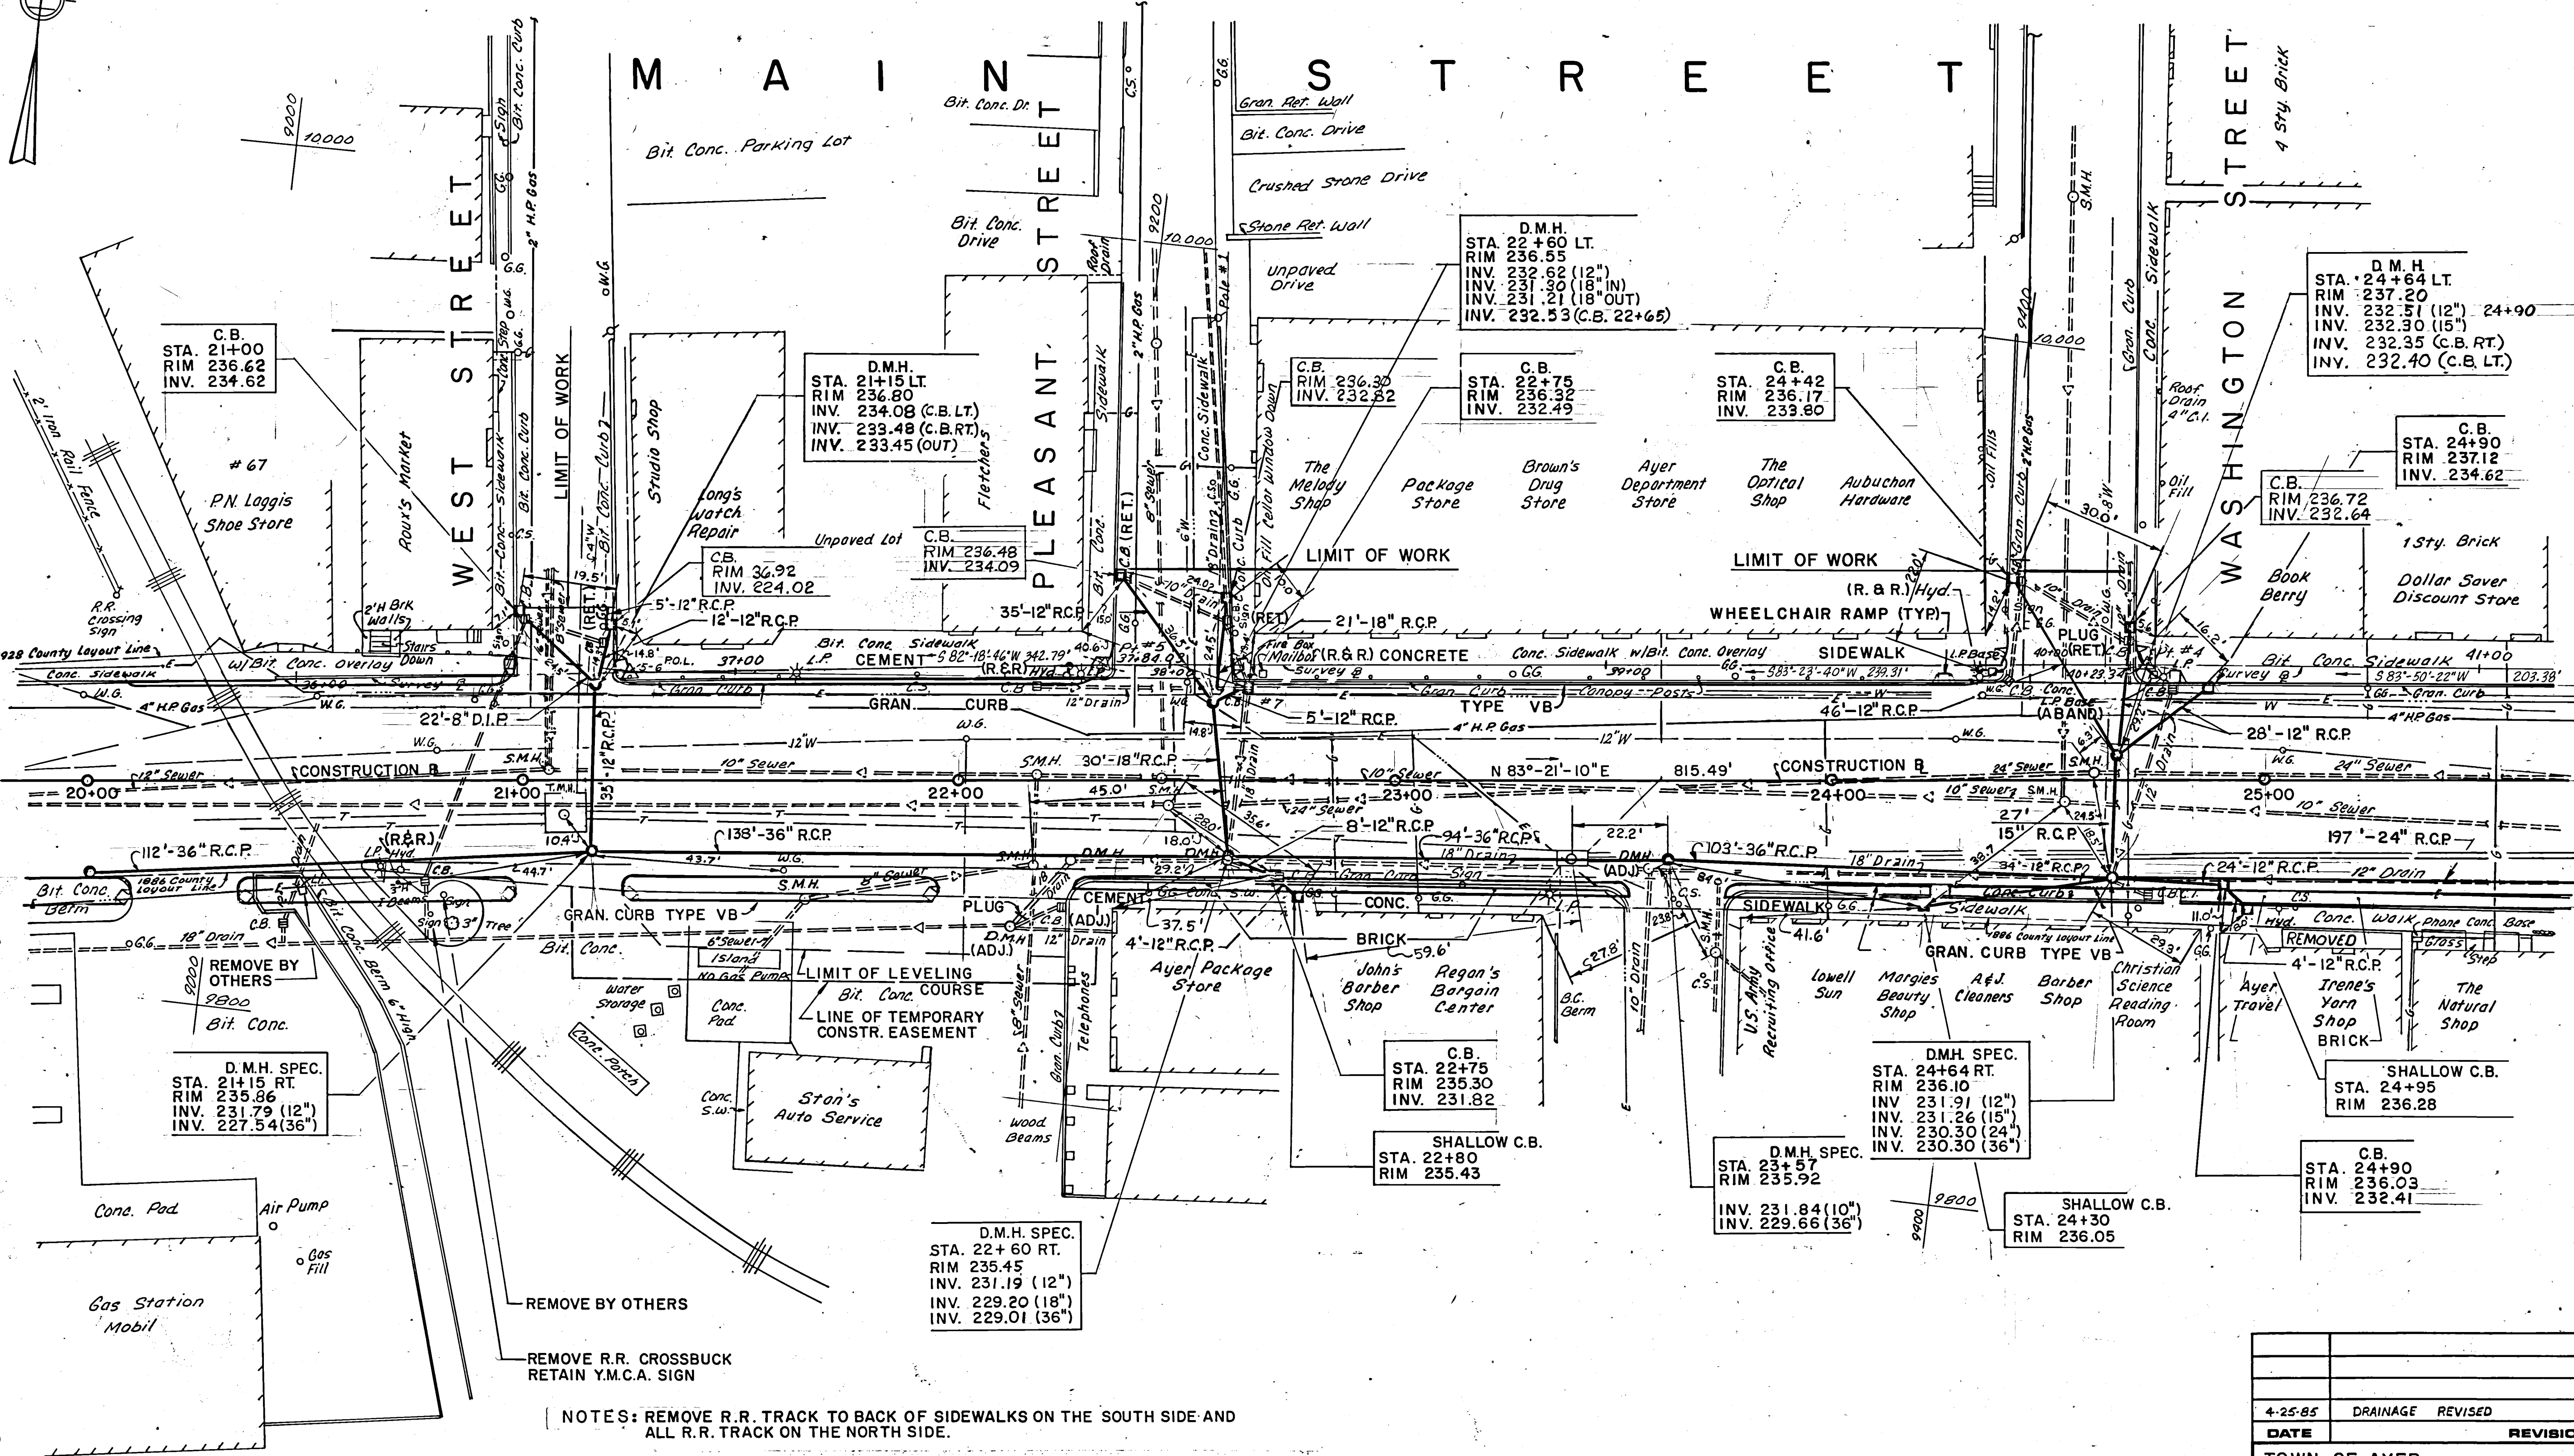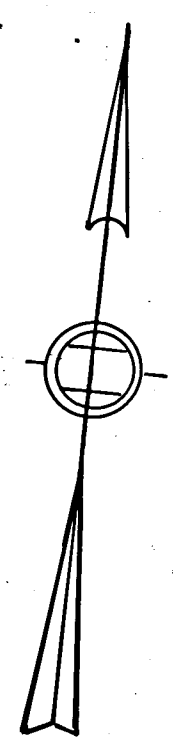

| DATE | REVISIONS |
|---------|------------------|
| 4-25-85 | DRAINAGE REVISED |

TOWN OF AYER MASSACHUSETTS
 DOWNTOWN REVITALIZATION
CONSTRUCTION PLAN
 STA. 20+00 TO STA. 25+50

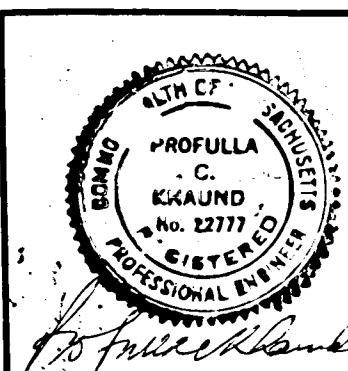

GREEN INTERNATIONAL AFFILIATES INC.
 CONSULTING ENGINEERS BOSTON MASSACHUSETTS


SCALE: 1" = 20'
 G.I.A. PROJECT NO. 8407

APPROVED: _____
 DESIGNED BY: J.J.M.
 DRAWN BY: D.K.
 CHECKED BY: J.F.M.

PLAN NO. 9 OF 20

AS BUILT DRAWING


HW #46

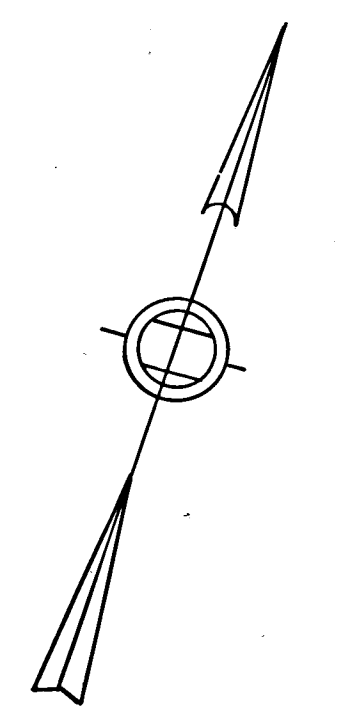

M
A
I
N

CENTRAL AVENUE
S
T
R
E
E
T

COLUMBIA STREET

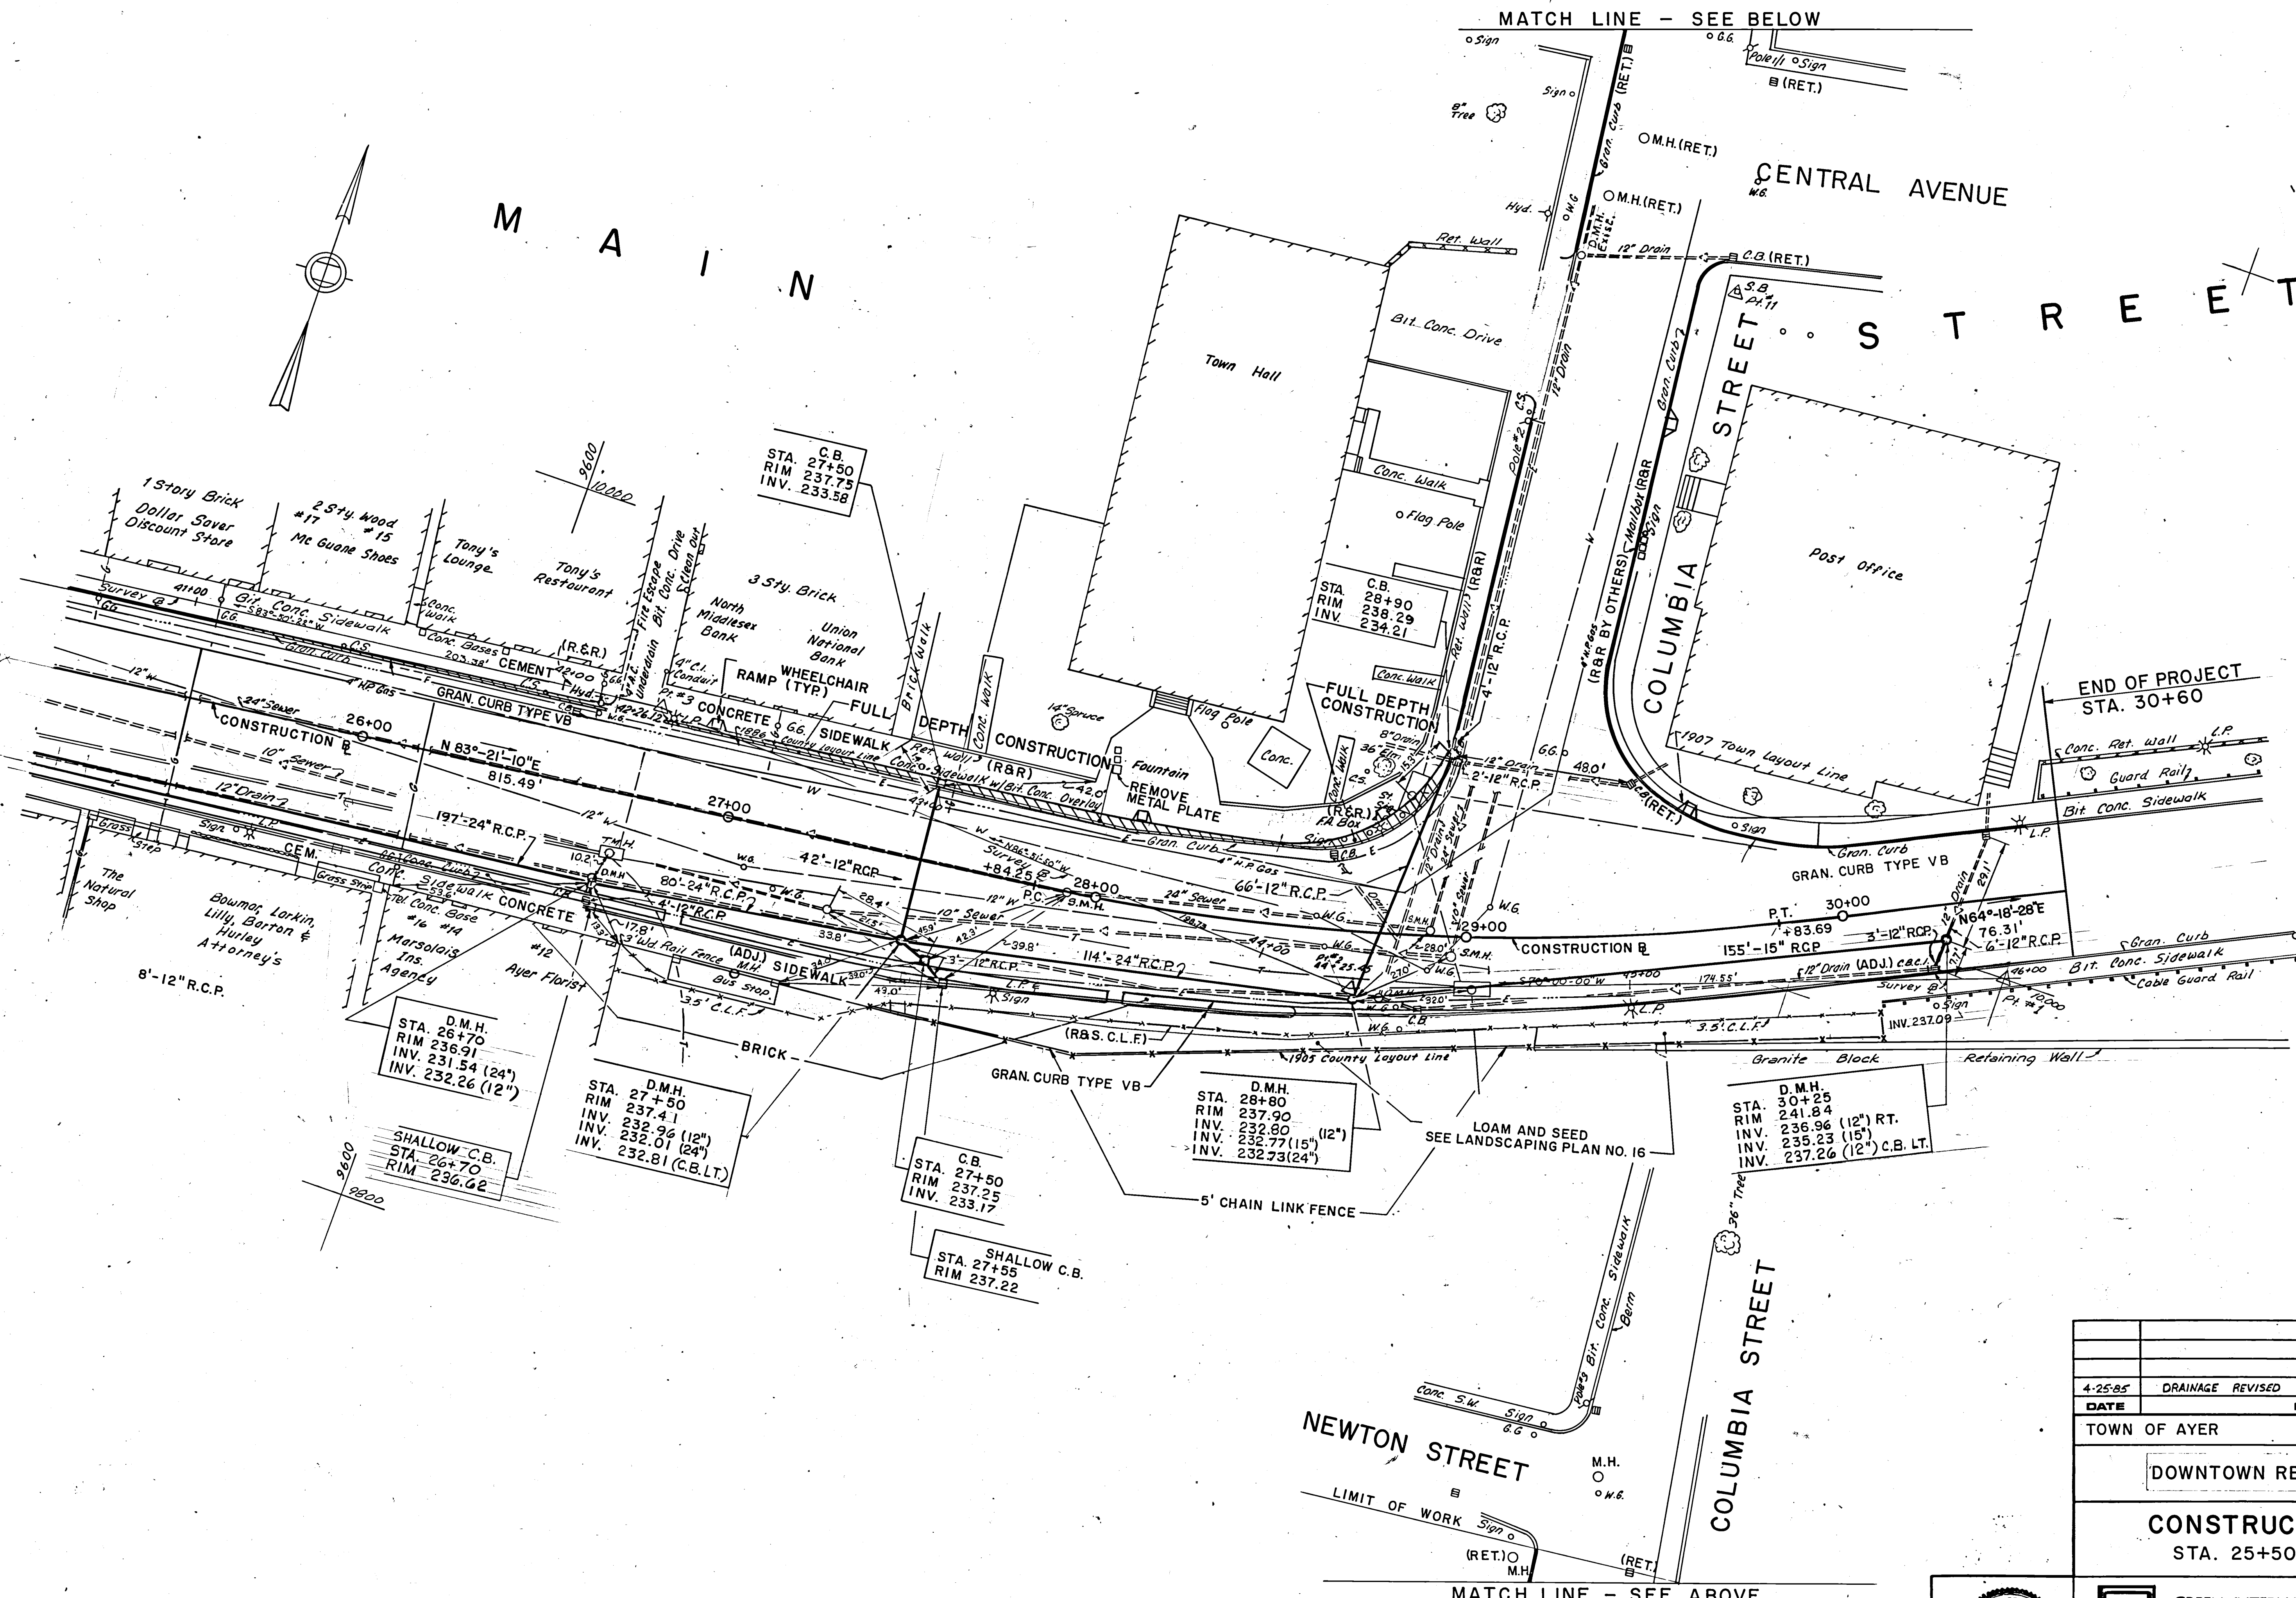

STA. D.M.H.
26+70
RIM 236.91
INV. 231.54 (24")
INV. 232.26 (12")

STA. D.M.H.
27+50
RIM 237.41
INV. 232.96 (12")
INV. 232.01 (24")
INV. 232.81 (C.B.LT.)

STA. C.B.
27+50
RIM 237.25
INV. 233.17

STA. SHALLOW C.B.
27+55
RIM 237.22

STA. D.M.H.
28+80
RIM 237.90
INV. 232.80 (12")
INV. 232.77 (15")
INV. 232.73 (24")

STA. D.M.H.
30+25
RIM 241.84
INV. 236.96 (12") RT.
INV. 235.23 (15")
INV. 237.26 (12") C.B. LT.


NEWTON STREET

COLUMBIA STREET

MATCH LINE - SEE ABOVE

AS BUILT DRAWING

| | |
|----------------------------------------------------------------------------------|---------------------------|
| 4-25-85 | DRAINAGE REVISED |
| DATE REVISIONS | |
| TOWN OF AYER | MASSACHUSETTS |
| DOWNTOWN REVITALIZATION | |
| CONSTRUCTION PLAN | |
| STA. 25+50 TO 30+60 | |
| GREEN INTERNATIONAL AFFILIATES INC. CONSULTING ENGINEERS BOSTON MASSACHUSETTS | |
| SCALE: 1" = 20' | G. I. A. PROJECT NO. 8407 |
| APPROVED: | DESIGNED BY: J.J.M. |
| DATE: | DRAWN BY: D.K. |
| | CHECKED BY: J.F.M. |
| | PLAN NO. 10 OF 20 |

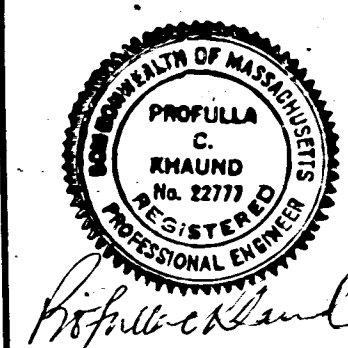

HW #46

DEPARTMENT OF PUBLIC WORKS

Mark L. Wetzel P.E., Superintendent
 Pamela J. Martin, Office Manager



Water, Wastewater, Highway & Solid Waste Divisions

25 BROOK STREET
 AYER, MASSACHUSETTS 01432
 T: (978) 772-8240
 F: (978) 772-8244

Date: Thursday January 16, 2020 9 AM
Subject: Pre-Proposal Meeting Main Street and Columbia Street Roadway Improvement Project
Location: Ayer Department of Public Works

Sign-in Sheet

| Name | Company | Address | Email | Phone |
|-------------------|------------------|-------------------------------------------|--------------------------------|--------------|
| Alyssa Peck | Weston + Sampson | 100 Foxboro Blvd. Foxboro, MA 01935 | pecka@wseinc.com | 508-203-8331 |
| Chris Deacetis | Kleinfelder | 1 Beacon St Suite 500 Boston, MA 02108 | chris.deacetis@kleinfelder.com | 617-498-4605 |
| Matt Soltyz | NITSCHE | 120 Front St, Suite 800 Worcester, MA | msoltyz@nitshenl.com | 508-964-3355 |
| Grey Russell | VHB | 120 Front St, Suite 500 Worcester, MA | grussell@vhb.com | 508-513-2716 |
| Robert Blanchette | GIMZ | 6 Chestnut St Amesbury MA | rblanchettejr@gimzinc.com | 978-518-7001 |
| DEIK ATKINS | GREEN INTL AFFL | 239 Littleton Rd Westford, MA | eatkins@greenintl.com | 978-723-0400 |
| Dan Ken Schalkwyk | Ayer DPW | | | |
| | | | | |
| | | | | |
